
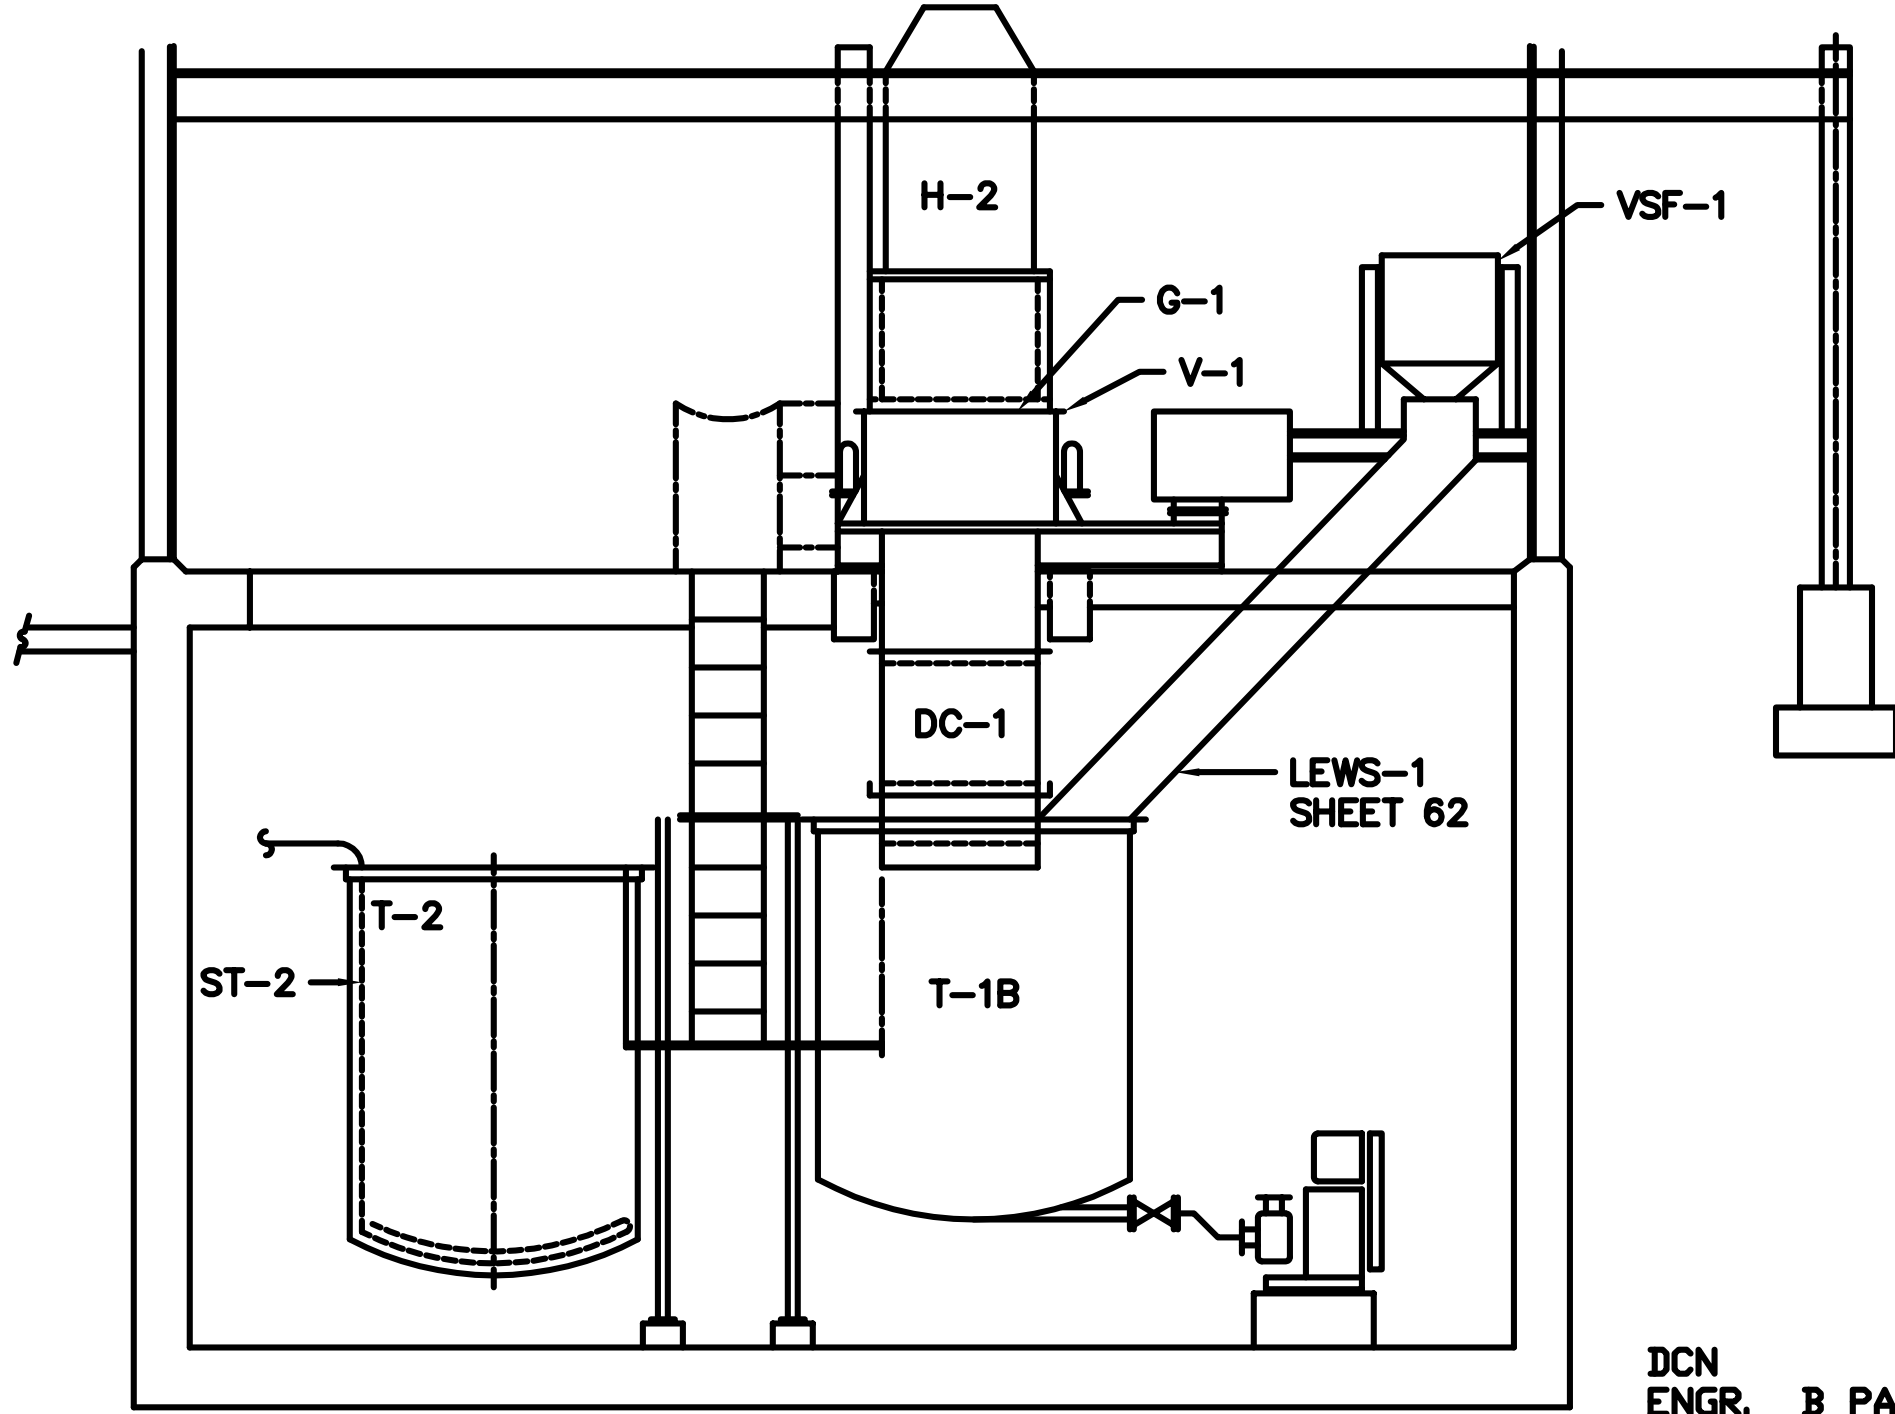


LOWER PLAN OF SLURRY PIT

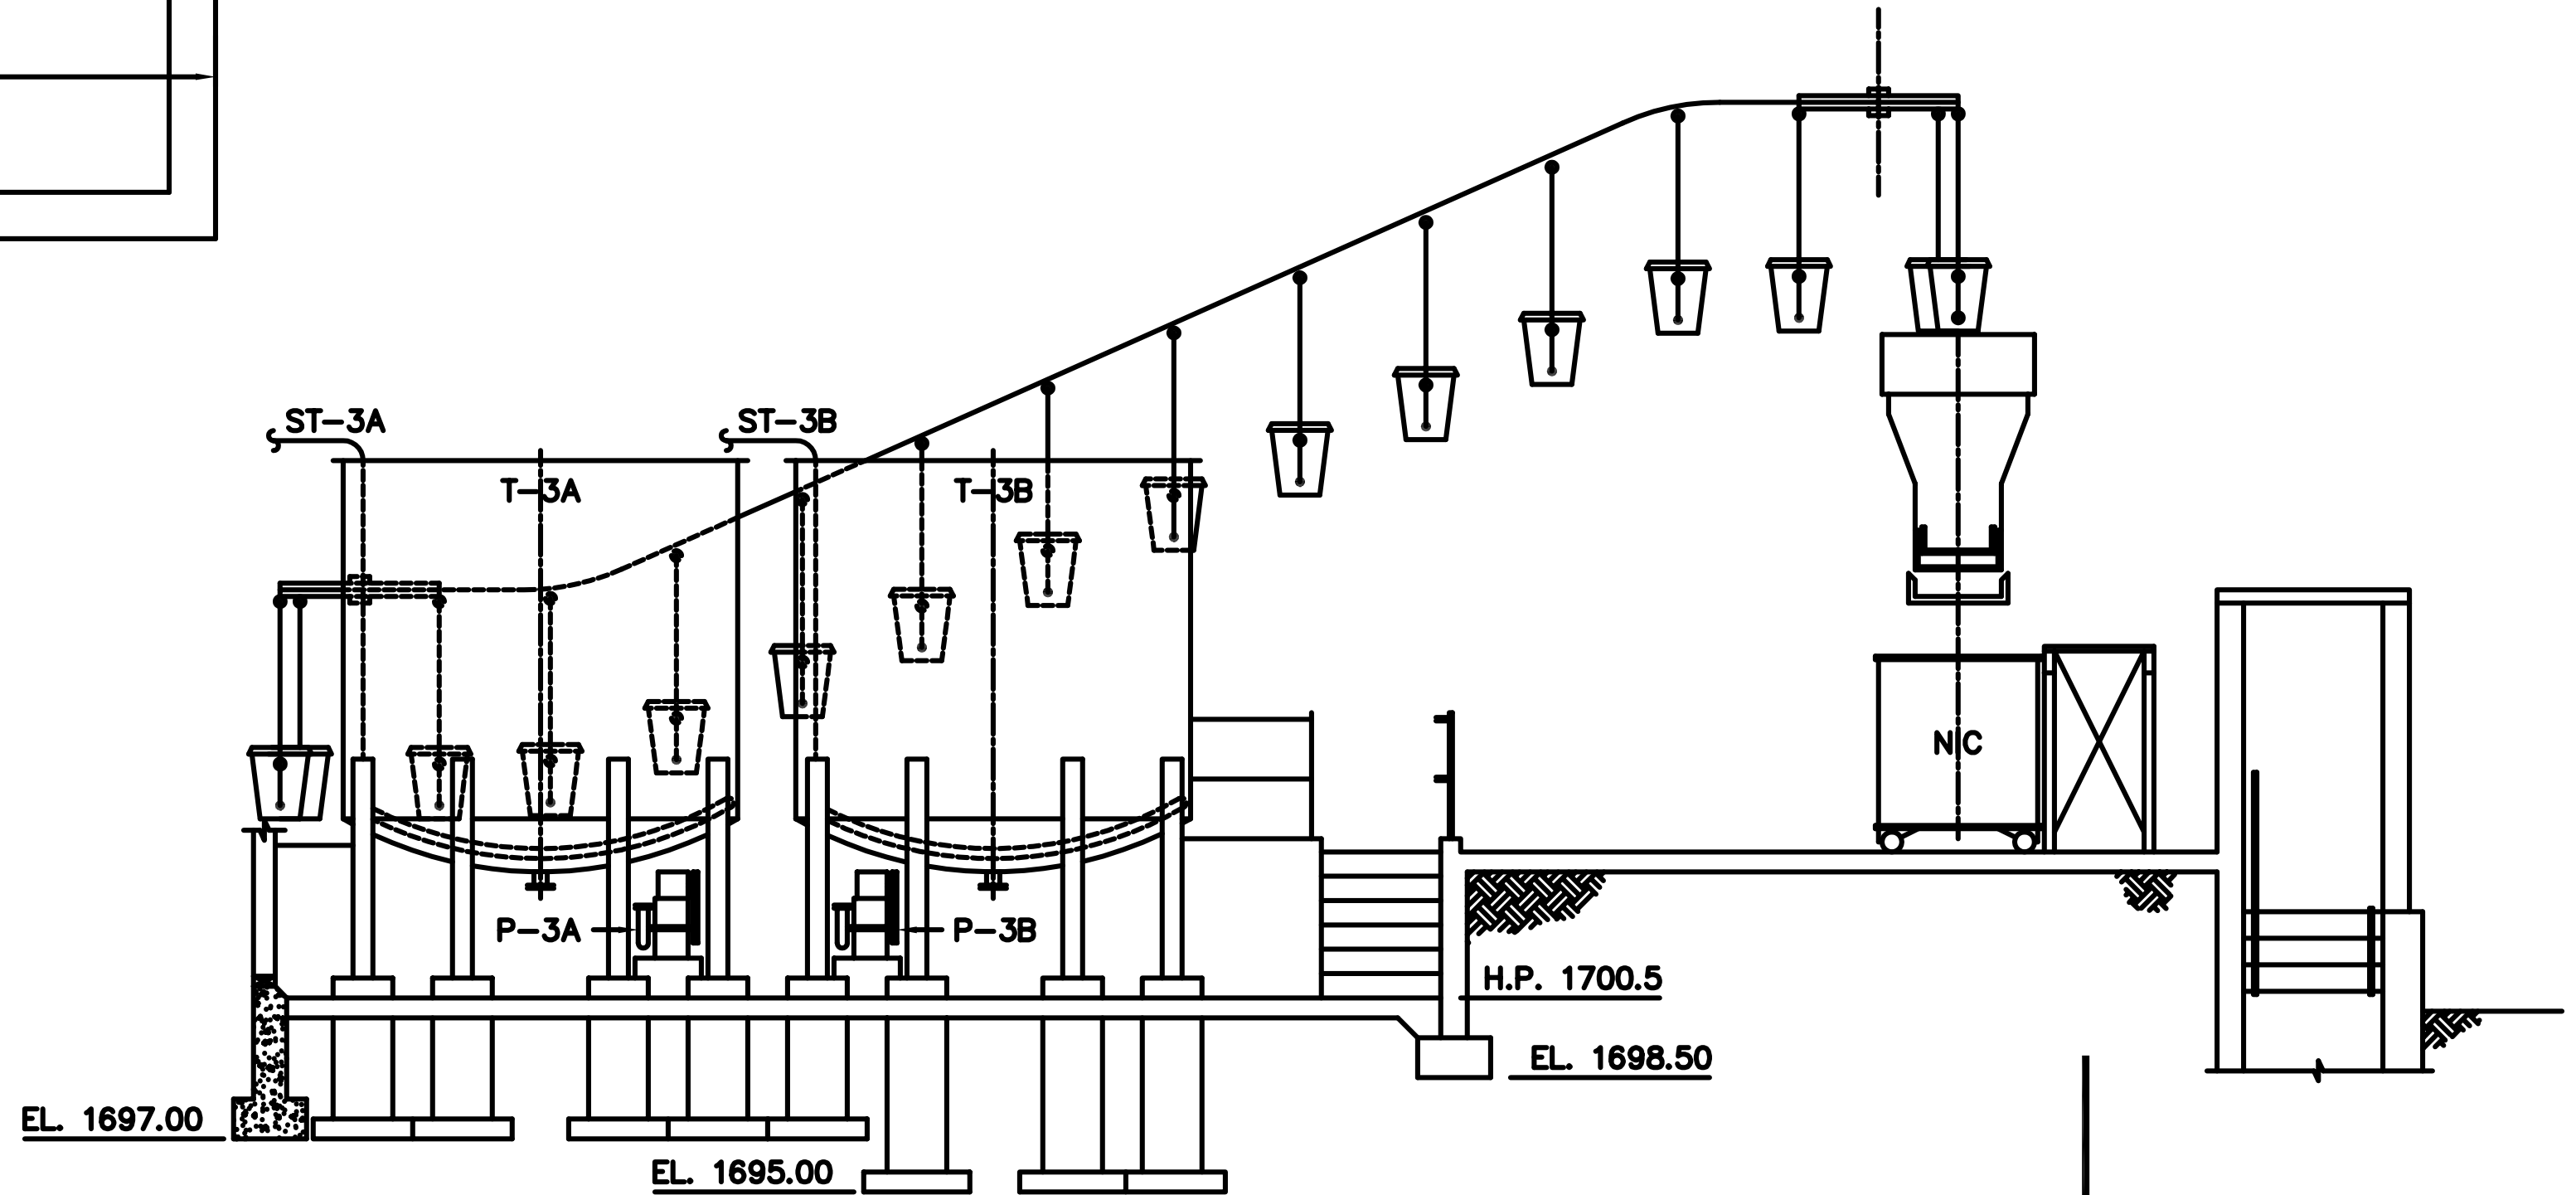

REVISIONS			
DESCRIPTION	DRAFTING	APPROVAL	
	DRAWN	DATE	CHECKED
AS-BUILT			

LEGEND	
C-1	TROLLEY CONVEYOR SYSTEM
H-1	DUMP HOPPER
C-2A	VIBRATING FEEDER
C-2B	VIBRATING CONVEYOR
H-2	GRINDER FEED HOPPER
G-1	GRINDER
V-1	VIBRATION MONITOR (SENSORS ONLY)
DC-1	DISCHARGE CHUTE
SD-1	SLURRY DIVERTER
T-1A	SLURRY TANK
T-1B	SLURRY TANK
A-1	SLURRY TANK AGITATOR
A-2	SLURRY TANK AGITATOR
T-2	MAKE UP TANK
T-3A	NEUTRALIZED CAUSTIC WASTE HOLDING TANK
T-3B	NEUTRALIZED CAUSTIC WASTE HOLDING TANK
ST-2	SPARGER - TANK T-2
ST-3A	SPARGER - TANK T-3A
ST-3B	SPARGER - TANK T-3B
LEWS-1	LIQUID EXPLOSIVE WASTE CHUTE
VSD-1	VIBRA-SCREW FEEDER
OMD-1	OVERSIZE MATERIAL DETECTOR
MD-1	METAL DETECTOR
NIC	NOT IN CONTACT
P-1A	SLURRY PUMP
P-1B	SLURRY PUMP
P-2	MAKE-UP PUMP
P-3A	NEUTRALIZED CAUSTIC WASTE PUMP
P-3B	NEUTRALIZED CAUSTIC WASTE PUMP

REDRAWN FROM ORIGINAL USING SAME NUMBER

L. MARTIN	
ENVIRONMENTAL APPROVAL	
TYPE	
CLASS	
DO NOT SCALE DRAWING	
TOLERANCES UNLESS OTHERWISE SPECIFIED	
DECIMAL	± .005
FRACTIONAL	± 1/16"
ANGULAR	± .005"

APPROVED FOR GENERAL DESIGN AND SPECIFICATIONS	
FOR ALLIANT TECHSYSTEMS	
J. GREFF	3/14/12
FOR U. S. GOVERNMENT	
N/A	DATE
N/A	DATE

CONTRACT NO. DAAA08-86-Z-0003	
PROJ	ACCOUNT NO
044200	025757F35300

SERIAL NO	
CLASS CODE	
REV	
044200	025757F35300